



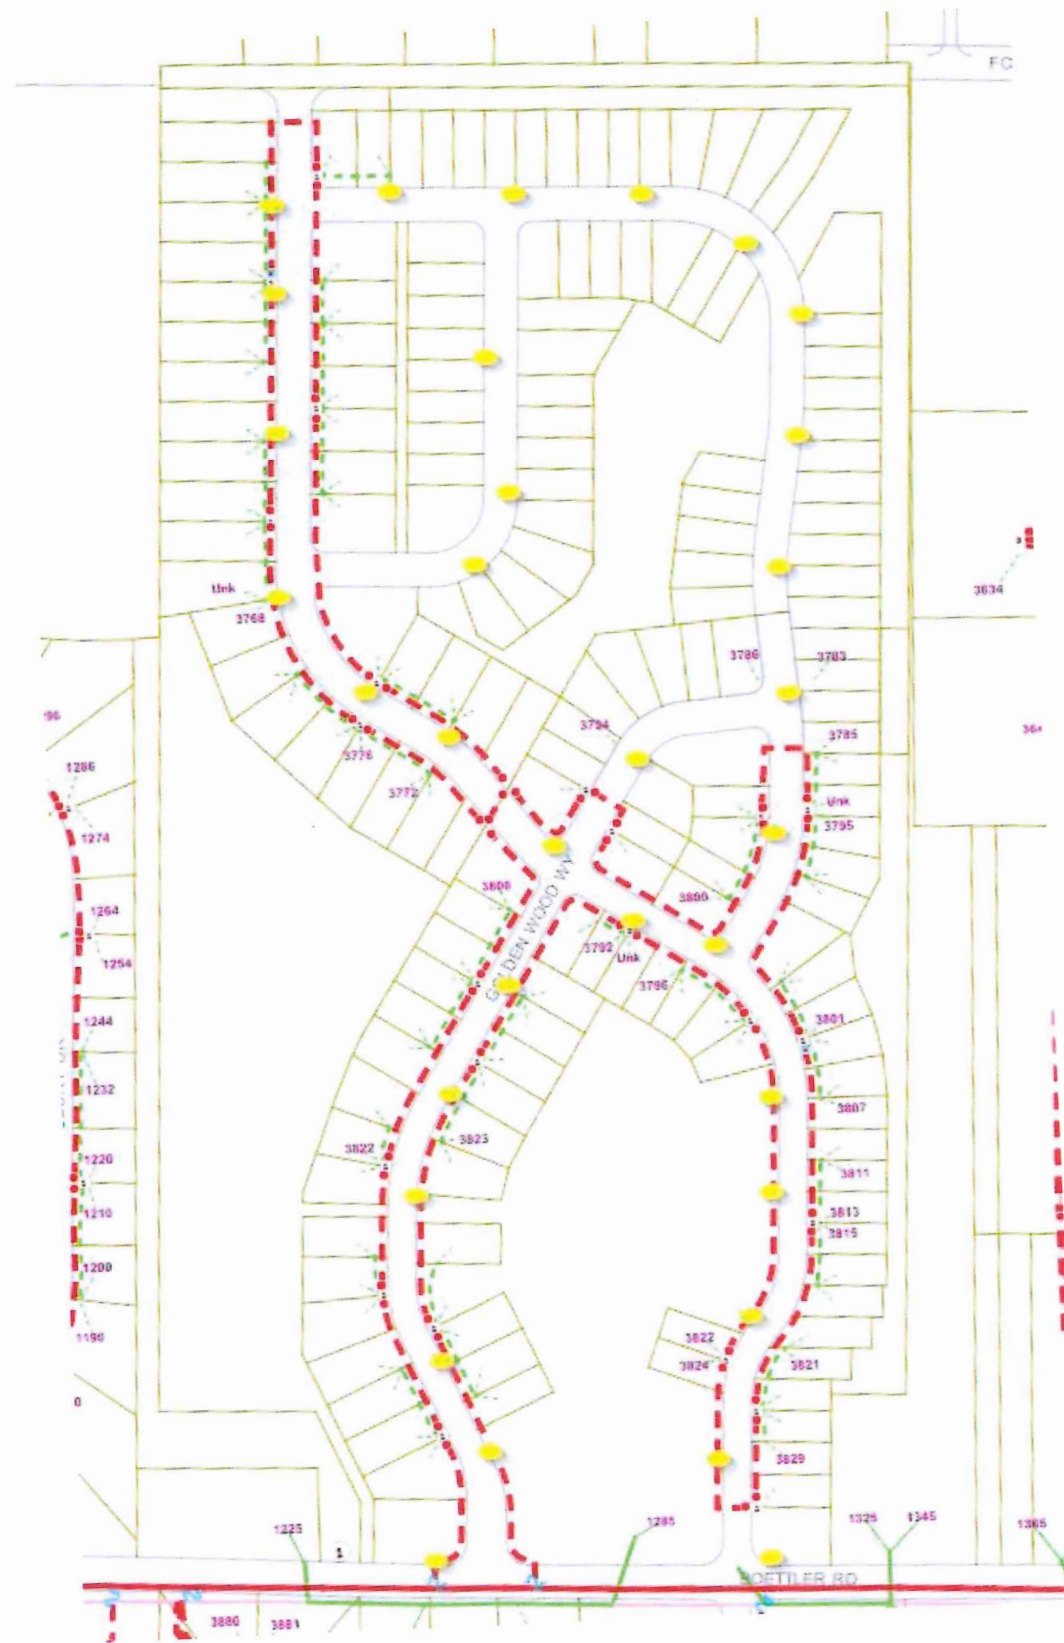

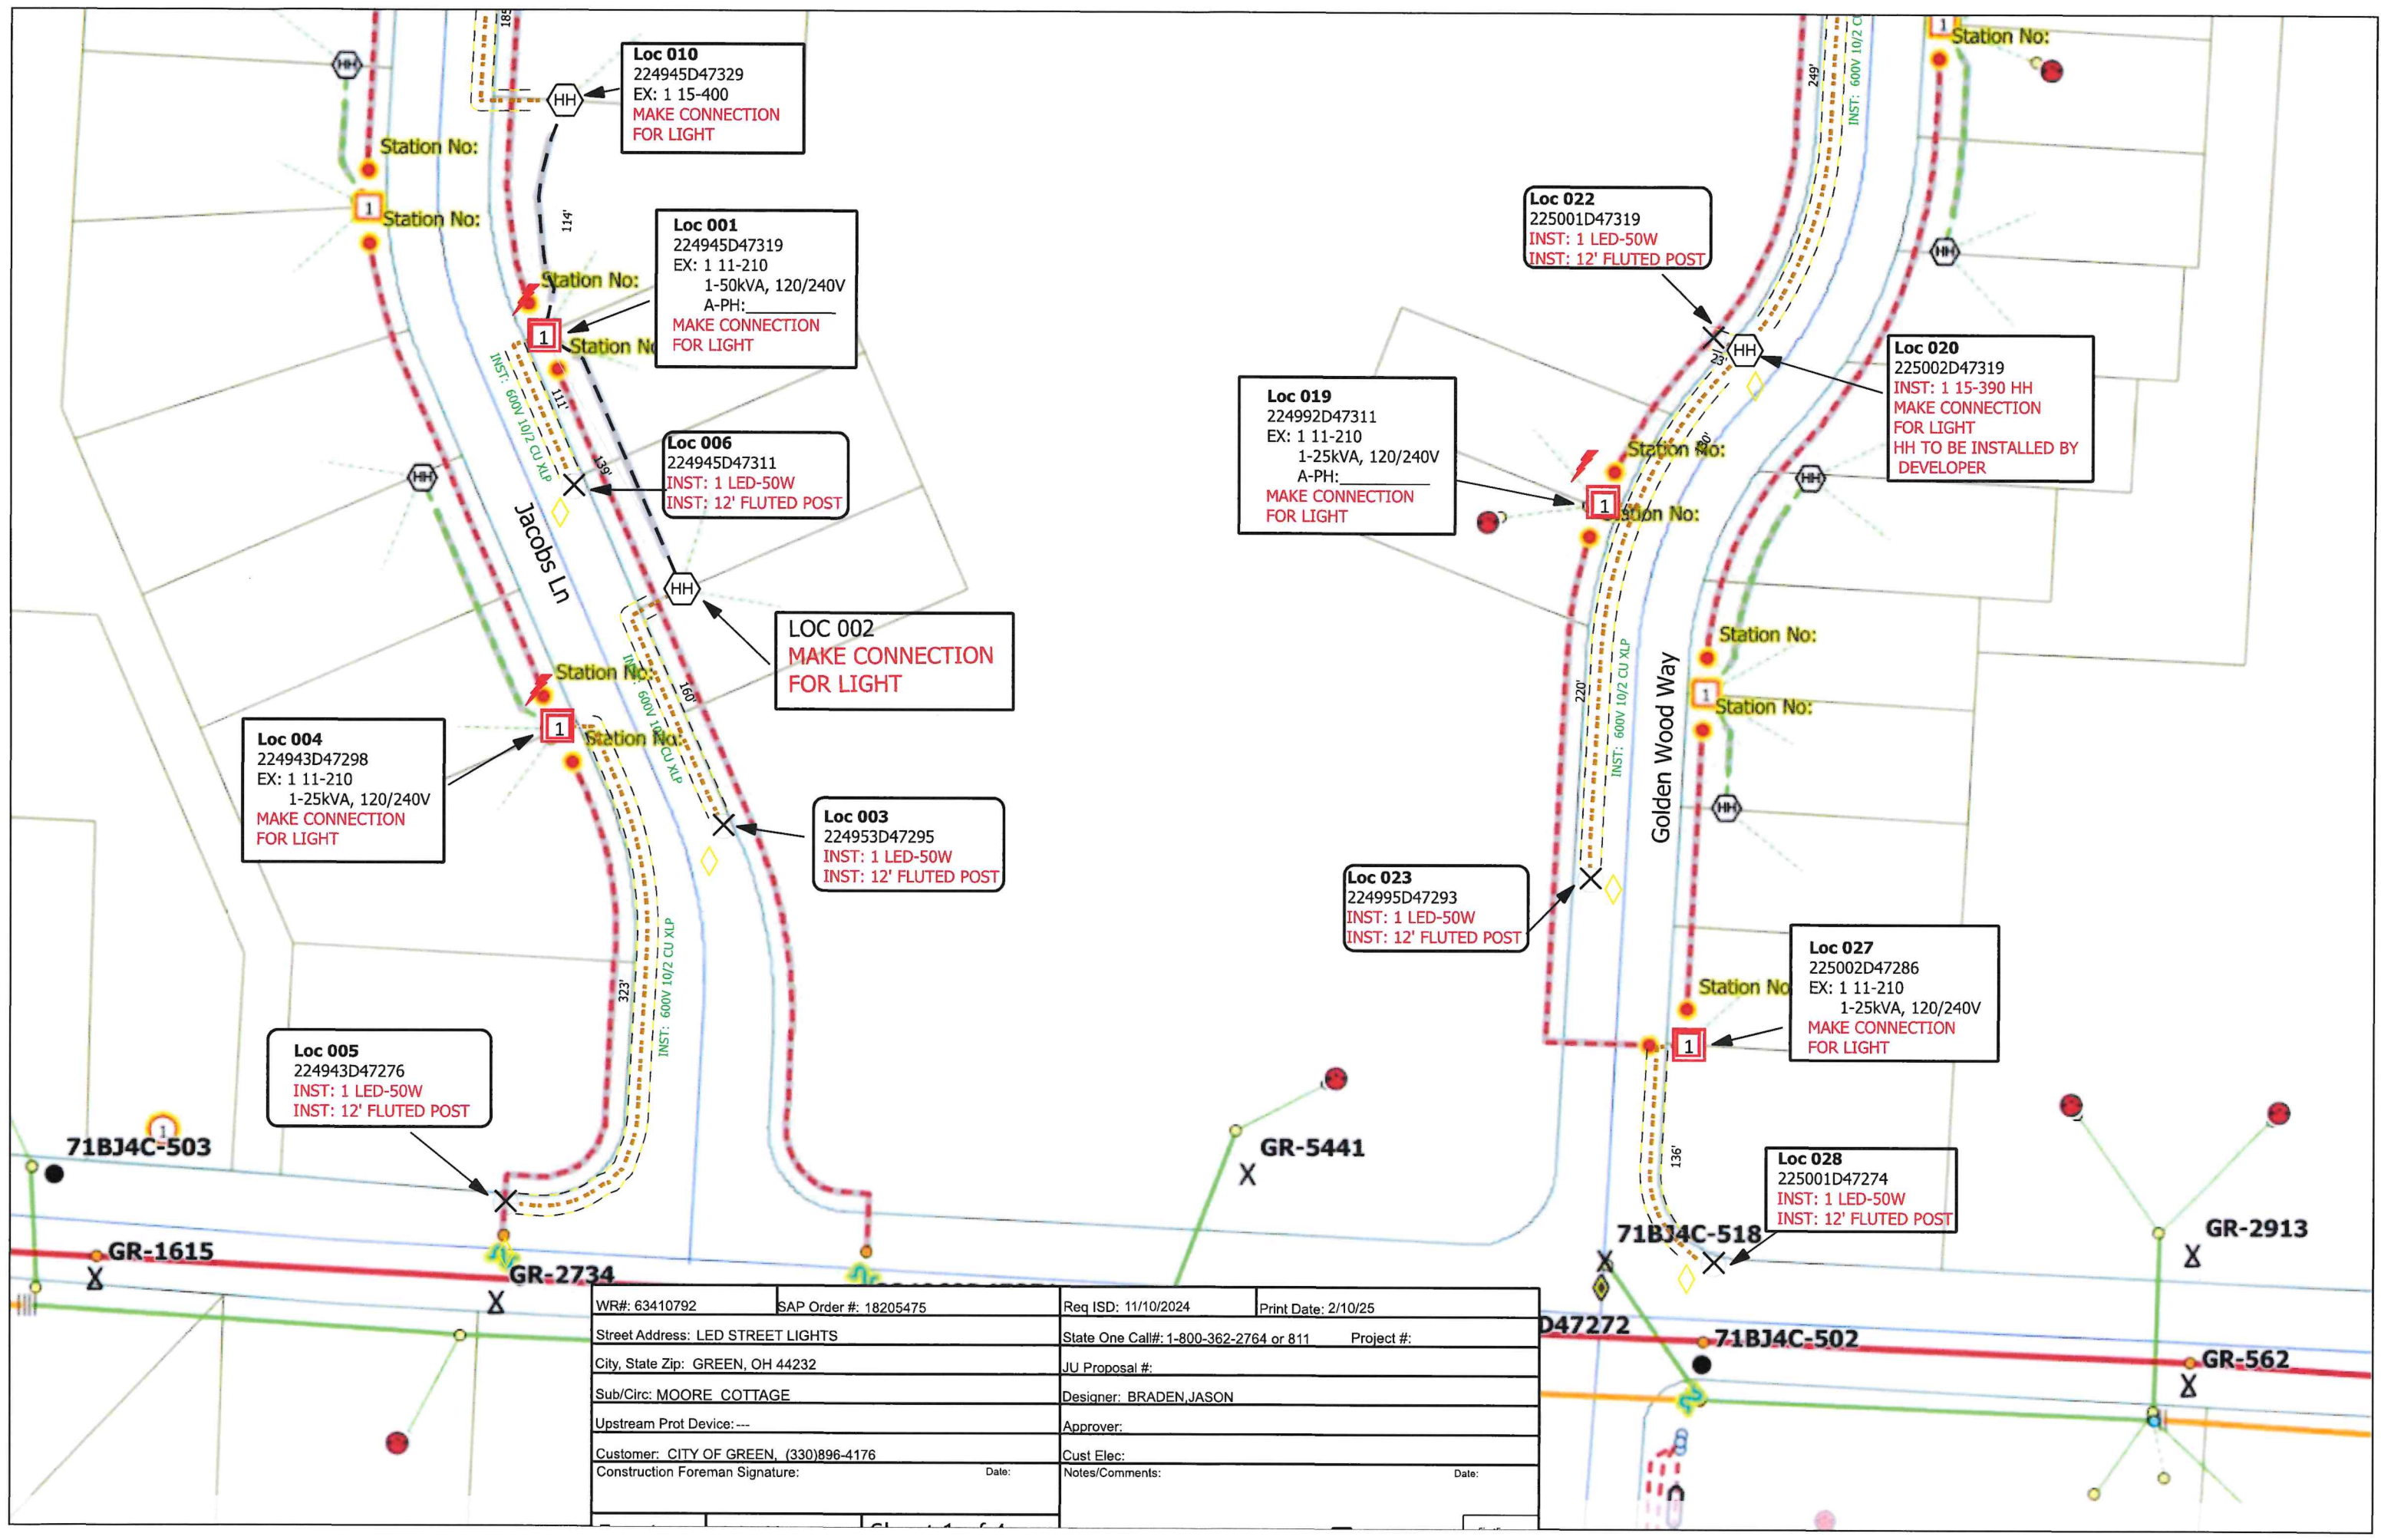

Loc 010
224945D47329
EX: 1 15-400
MAKE CONNECTION
FOR LIGHT

Loc 001
224945D47319
EX: 1 11-210
1-50kVA, 120/240V
A-PH:
MAKE CONNECTION
FOR LIGHT

Loc 006
224945D47311
INST: 1 LED-50W
INST: 12' FLUTED POST

LOC 002
MAKE CONNECTION
FOR LIGHT

Loc 003
224953D47295
INST: 1 LED-50W
INST: 12' FLUTED POST

Loc 004
224943D47298
EX: 1 11-210
1-25kVA, 120/240V
MAKE CONNECTION
FOR LIGHT

Loc 005
224943D47276
INST: 1 LED-50W
INST: 12' FLUTED POST

Loc 022
225001D47319
INST: 1 LED-50W
INST: 12' FLUTED POST

Loc 020
225002D47319
INST: 1 15-390 HH
MAKE CONNECTION
FOR LIGHT
HH TO BE INSTALLED BY
DEVELOPER


Loc 019
224992D47311
EX: 1 11-210
1-25kVA, 120/240V
A-PH:
MAKE CONNECTION
FOR LIGHT

Loc 023
224995D47293
INST: 1 LED-50W
INST: 12' FLUTED POST

Loc 027
225002D47286
EX: 1 11-210
1-25kVA, 120/240V
MAKE CONNECTION
FOR LIGHT

Loc 028
225001D47274
INST: 1 LED-50W
INST: 12' FLUTED POST

WR#: 63410792	SAP Order #: 18205475	Req ISD: 11/10/2024	Print Date: 2/10/25
Street Address: LED STREET LIGHTS		State One Call#: 1-800-362-2764 or 811	Project #:
City, State Zip: GREEN, OH 44232		JU Proposal #:	
Sub/Circ: MOORE COTTAGE		Designer: BRADEN,JASON	
Upstream Prot Device: ---		Approver:	
Customer: CITY OF GREEN, (330)896-4176		Cust Elec:	
Construction Foreman Signature:	Date:	Notes/Comments:	Date:

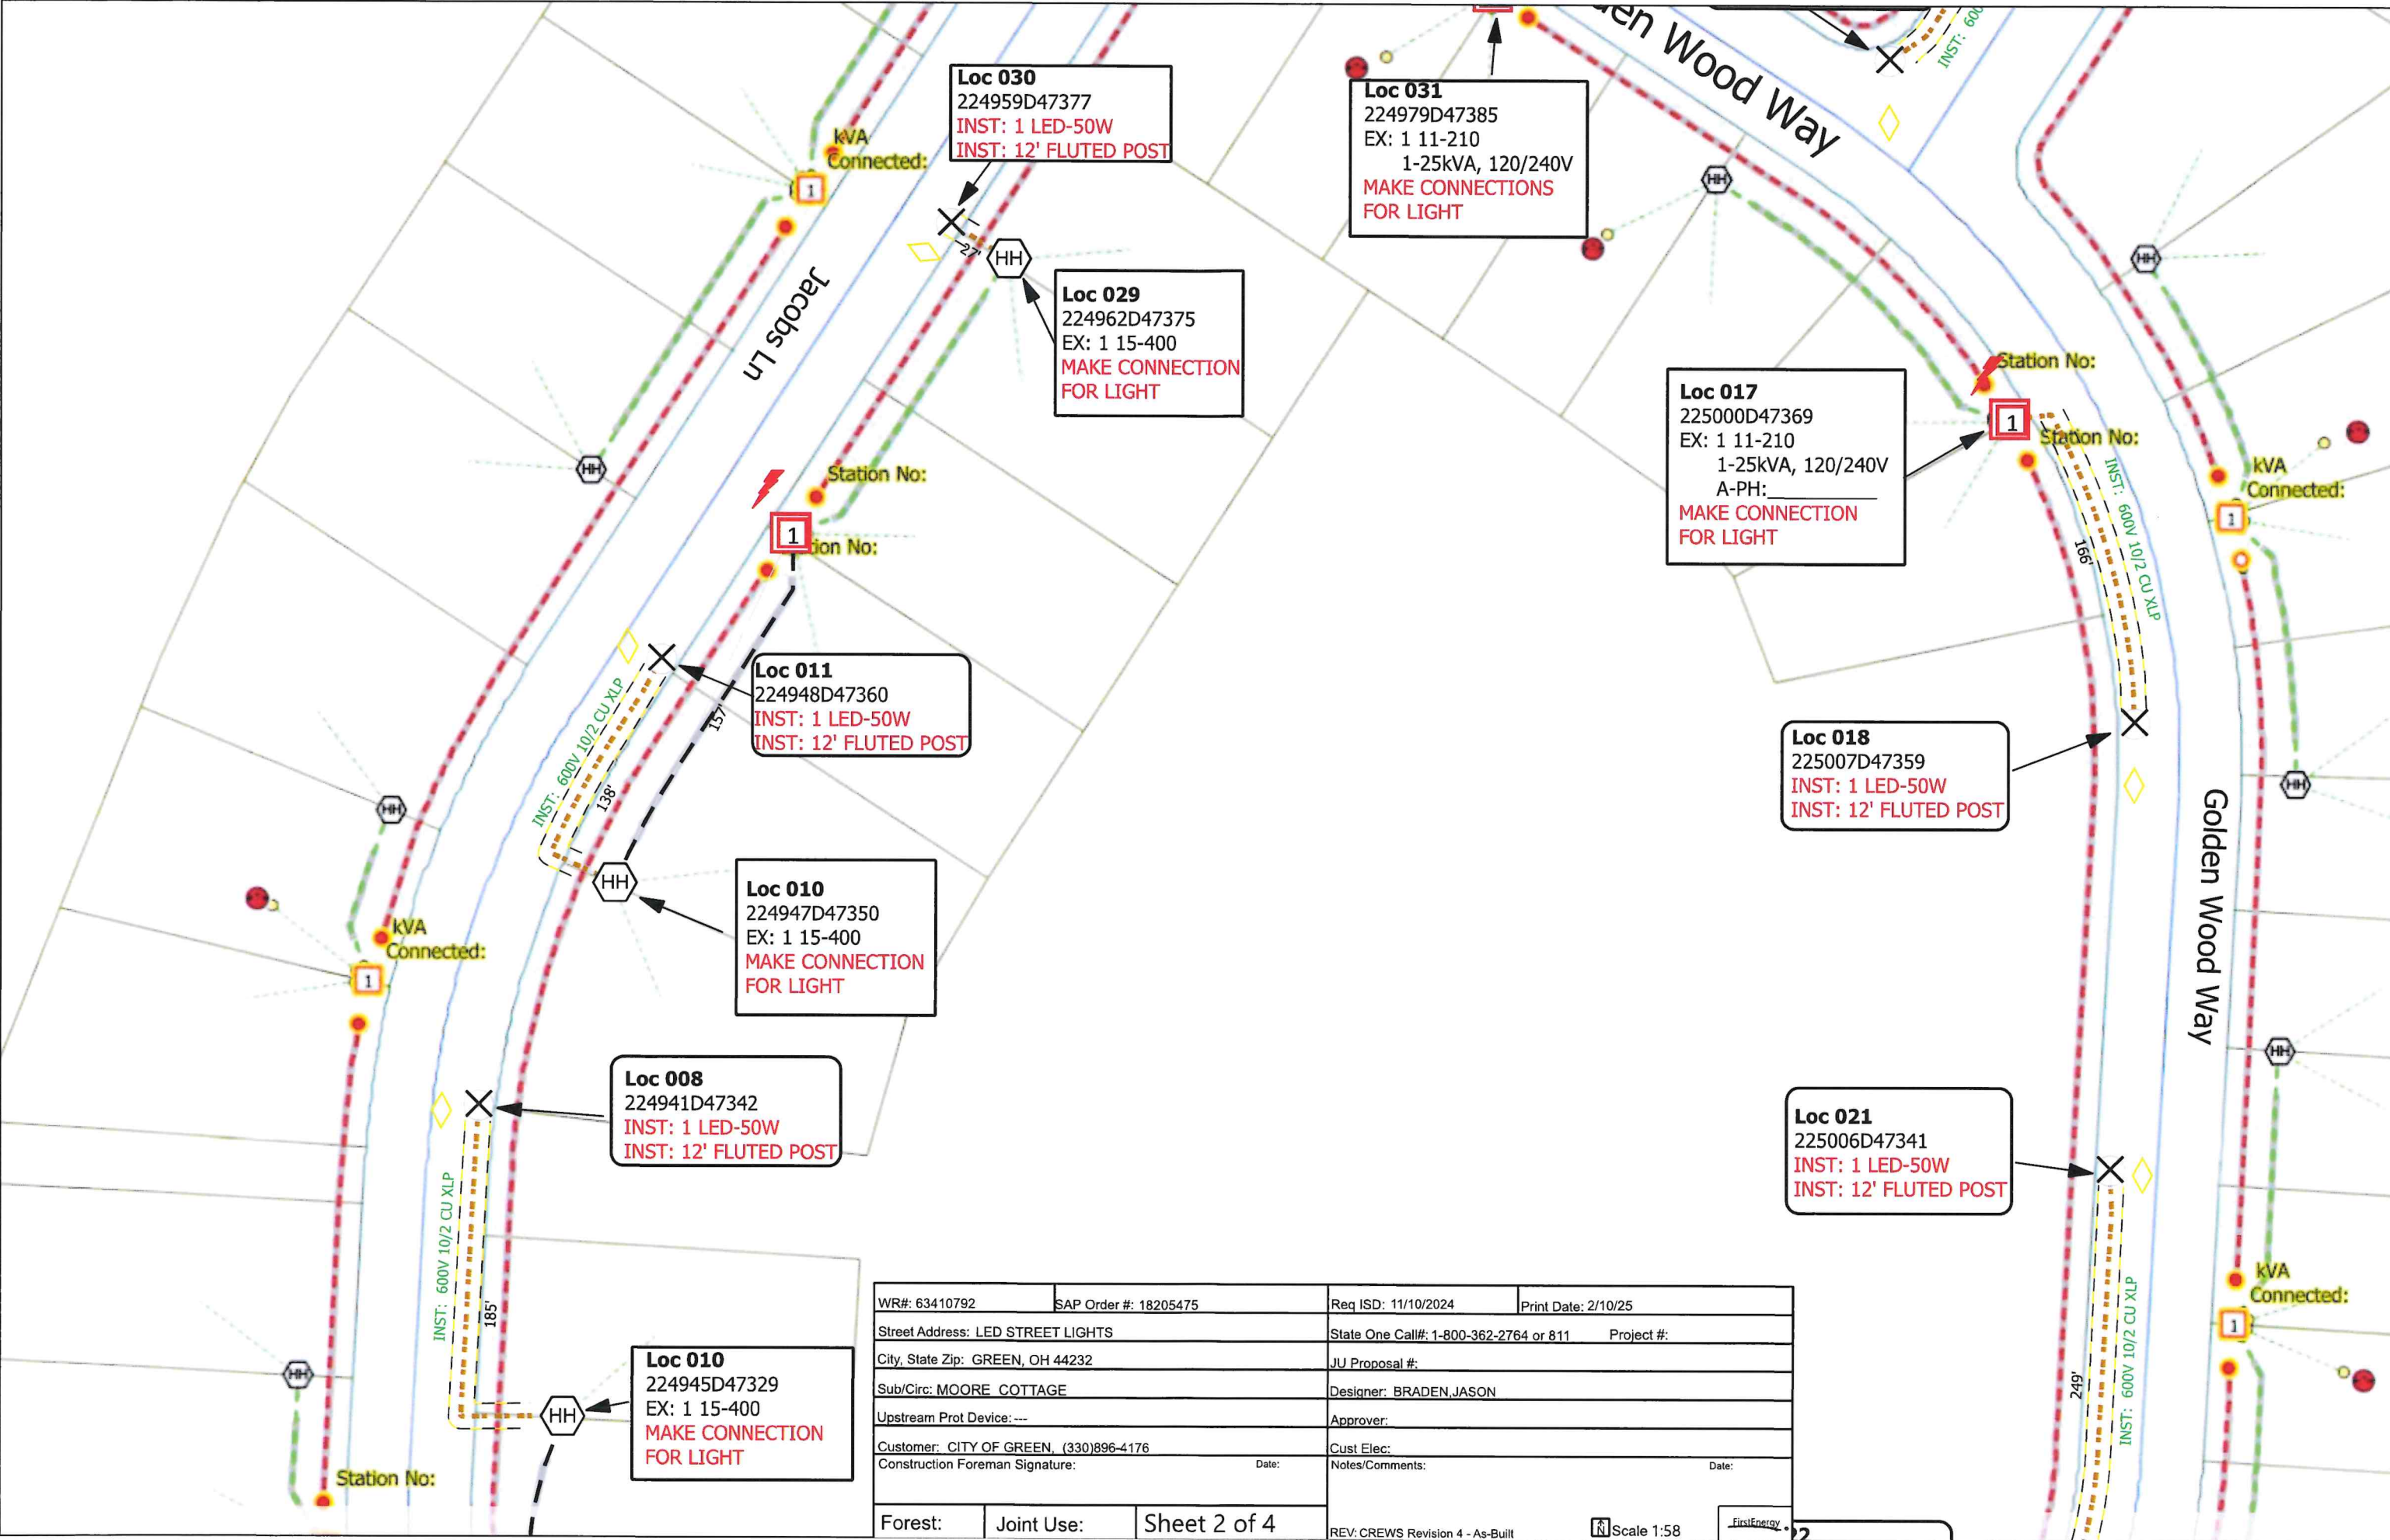

Loc 030
224959D47377
INST: 1 LED-50W
INST: 12' FLUTED POST

Loc 031
224979D47385
EX: 1 11-210
1-25kVA, 120/240V
MAKE CONNECTIONS
FOR LIGHT

Loc 029
224962D47375
EX: 1 15-400
MAKE CONNECTION
FOR LIGHT

Loc 017
225000D47369
EX: 1 11-210
1-25kVA, 120/240V
A-PH:
MAKE CONNECTION
FOR LIGHT

Loc 011
224948D47360
INST: 1 LED-50W
INST: 12' FLUTED POST

Loc 018
225007D47359
INST: 1 LED-50W
INST: 12' FLUTED POST

Loc 010
224947D47350
EX: 1 15-400
MAKE CONNECTION
FOR LIGHT

Loc 008
224941D47342
INST: 1 LED-50W
INST: 12' FLUTED POST

Loc 021
225006D47341
INST: 1 LED-50W
INST: 12' FLUTED POST

Loc 010
224945D47329
EX: 1 15-400
MAKE CONNECTION
FOR LIGHT

WR#: 63410792	SAP Order #: 18205475	Req ISD: 11/10/2024	Print Date: 2/10/25
Street Address: LED STREET LIGHTS	State One Call#: 1-800-362-2764 or 811	Project #:	
City, State Zip: GREEN, OH 44232	JU Proposal #:		
Sub/Circ: MOORE COTTAGE	Designer: BRADEN, JASON		
Upstream Prot Device: ---	Approver:		
Customer: CITY OF GREEN, (330)896-4176	Cust Elec:		
Construction Foreman Signature:	Date:	Notes/Comments:	Date:
Forest:	Joint Use:	Sheet 2 of 4	REV: CREWS Revision 4 - As-Built

Scale 1:58

FirstEnergy

OE TO INSTALL

- (15) - 50w LED Luminaire Acorn
- (15) - Pole foundation screw in type
- (15) - 12' Fluted post black

2358' of CU 2/c #10 w/ground UF cable

Step 1: OE to install screw in base at each light location (15). Will have to do 811 before we dig.

Step 2: Developer to adjust conduit into each base (15)

Step 3: OE to mount light post top to each base and run conductor from HH/transformer to lights and make connections.

Developer/Contractor Notes

Developer to prepare ground for a Handhole at location 20. See file emailed for requirements.

At each light location, developer to extend conduits into the screw in light bases.

WR#: 63410792	SAP Order #: 18205475	Req ISD: 11/10/2024	Print Date: 2/10/25
Street Address: LED STREET LIGHTS	State One Call#: 1-800-362-2764 or 811	Project #:	
City, State Zip: GREEN, OH 44232	JU Proposal #:		
Sub/Circ: MOORE COTTAGE	Designer: BRADEN,JASON		
Upstream Prot Device: ---	Approver:		
Customer: CITY OF GREEN, (330)896-4176	Cust Elec:		
Construction Foreman Signature:	Notes/Comments:	Date:	
Forest:	Joint Use:	Sheet 4 of 4	REV: CREWS Revision 4 - As-Built

Scale 1:155

FirstEnergy

